



BESTON LODGE
CROSSDALE STREET
NORTHREPPS
NR27 8LA
TEL: 07476 390665
EMAIL: dfcontracts@outlook.com


PROJECT

**BUTTERCUPS CAFE
5 HIGH STREET
CROMER
NR27 9HG**

DATE: JUNE 2024
PROJECT NO. 585

REVISION DATE

- NOTES:
1. DO NOT SCALE FROM THIS DRAWING.
 2. THE AUTHOR OF THIS DRAWING TAKES NO RESPONSIBILITY FOR ANY DIMENSIONS OBTAINED BY MEASURING OR SCALING FROM THIS DRAWING AND NO RELIANCE MAY BE PLACED ON SUCH DIMENSIONS.
 3. REPORT ALL DRAWING ERRORS, OMISSIONS AND DISCREPANCIES.

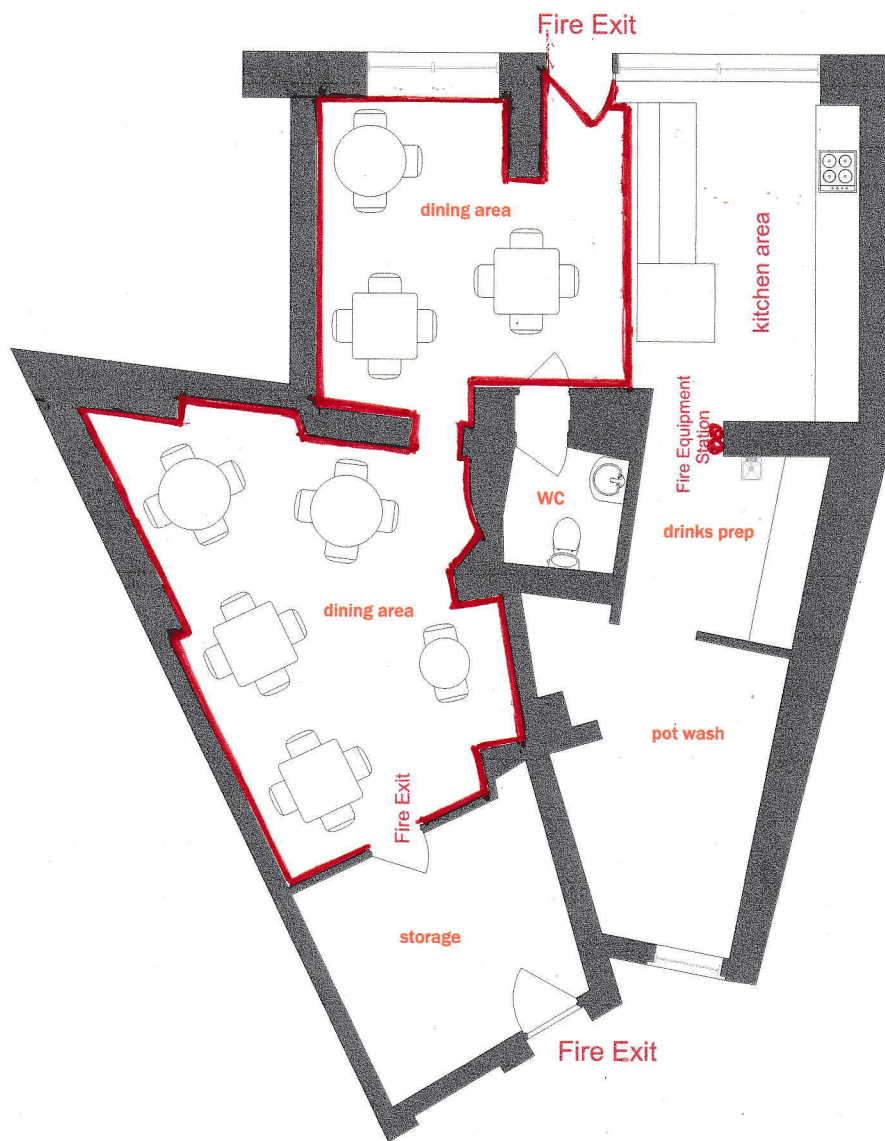

Fire exit route

1 EXISTING GROUND FLOOR PLAN
SCALE: 1:500

AS BUILT DRAWING

EXISTING
FLOOR
LAYOUT

SCALE: AS STATED @ A4

DWG
585.01

DRAWN BY: DAF